


1-12-26 Asbrtts Only

Vicinity Map (NTS)

Flood Certification
I have examined the Flood Insurance Rate Map for Union County North Carolina, Community Panel Number 3710541600J, dated October 16, 2008 and hereby certify that this property is not located in a special flood hazard area as determined by the Federal Emergency Management Agency.

Grid 1983

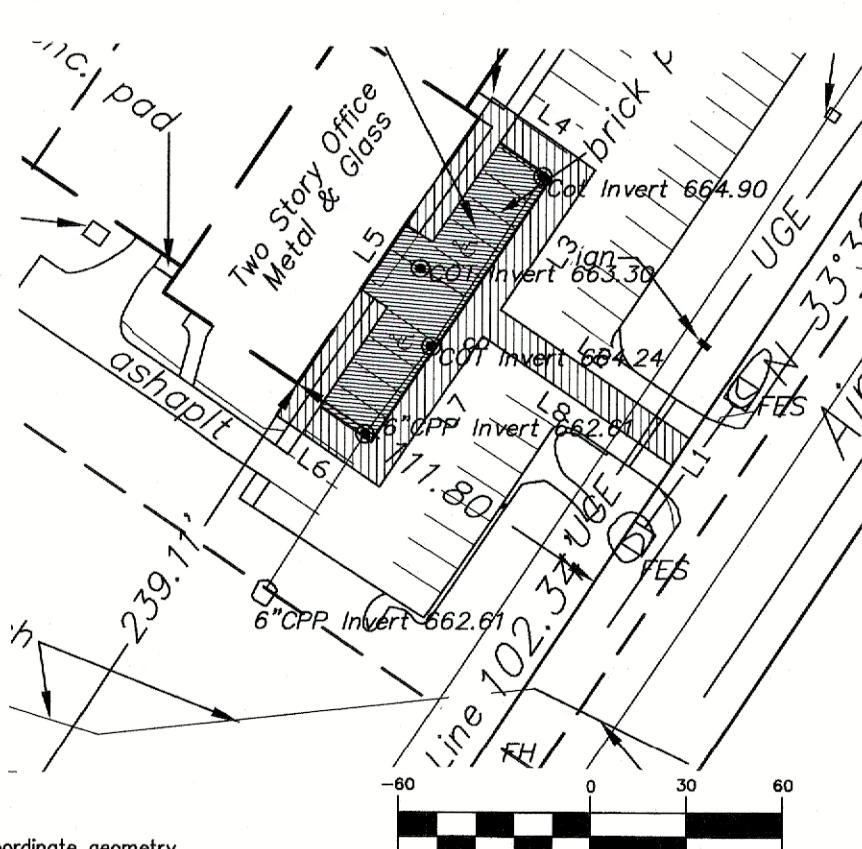


Site Data:
Tax Parcel: 09369007C80
Zoning: GI
Setbacks:
25' Front
10' Side
25' Rear

NOTES


1. Areas computed using coordinate geometry.
2. This map was prepared without the benefit of a title search.
3. Survey subject to full title search.
4. This property may be subject to right of ways, easements, restrictions and covenants either recorded or implied.
5. All distances shown are horizontal ground distances.
6. Rebar set at all corners unless otherwise noted.
7. Broken lines indicate property lines not surveyed.
8. All adjoining property owner information is taken from current
9. deeds and tax records and are considered as "Now or Formerly".
10. Lawrence Associates makes no guarantees to the compaction or to the nonexistence of spoils areas.
11. Other underground utilities may exist but their locations are not known.

(IN FEET)

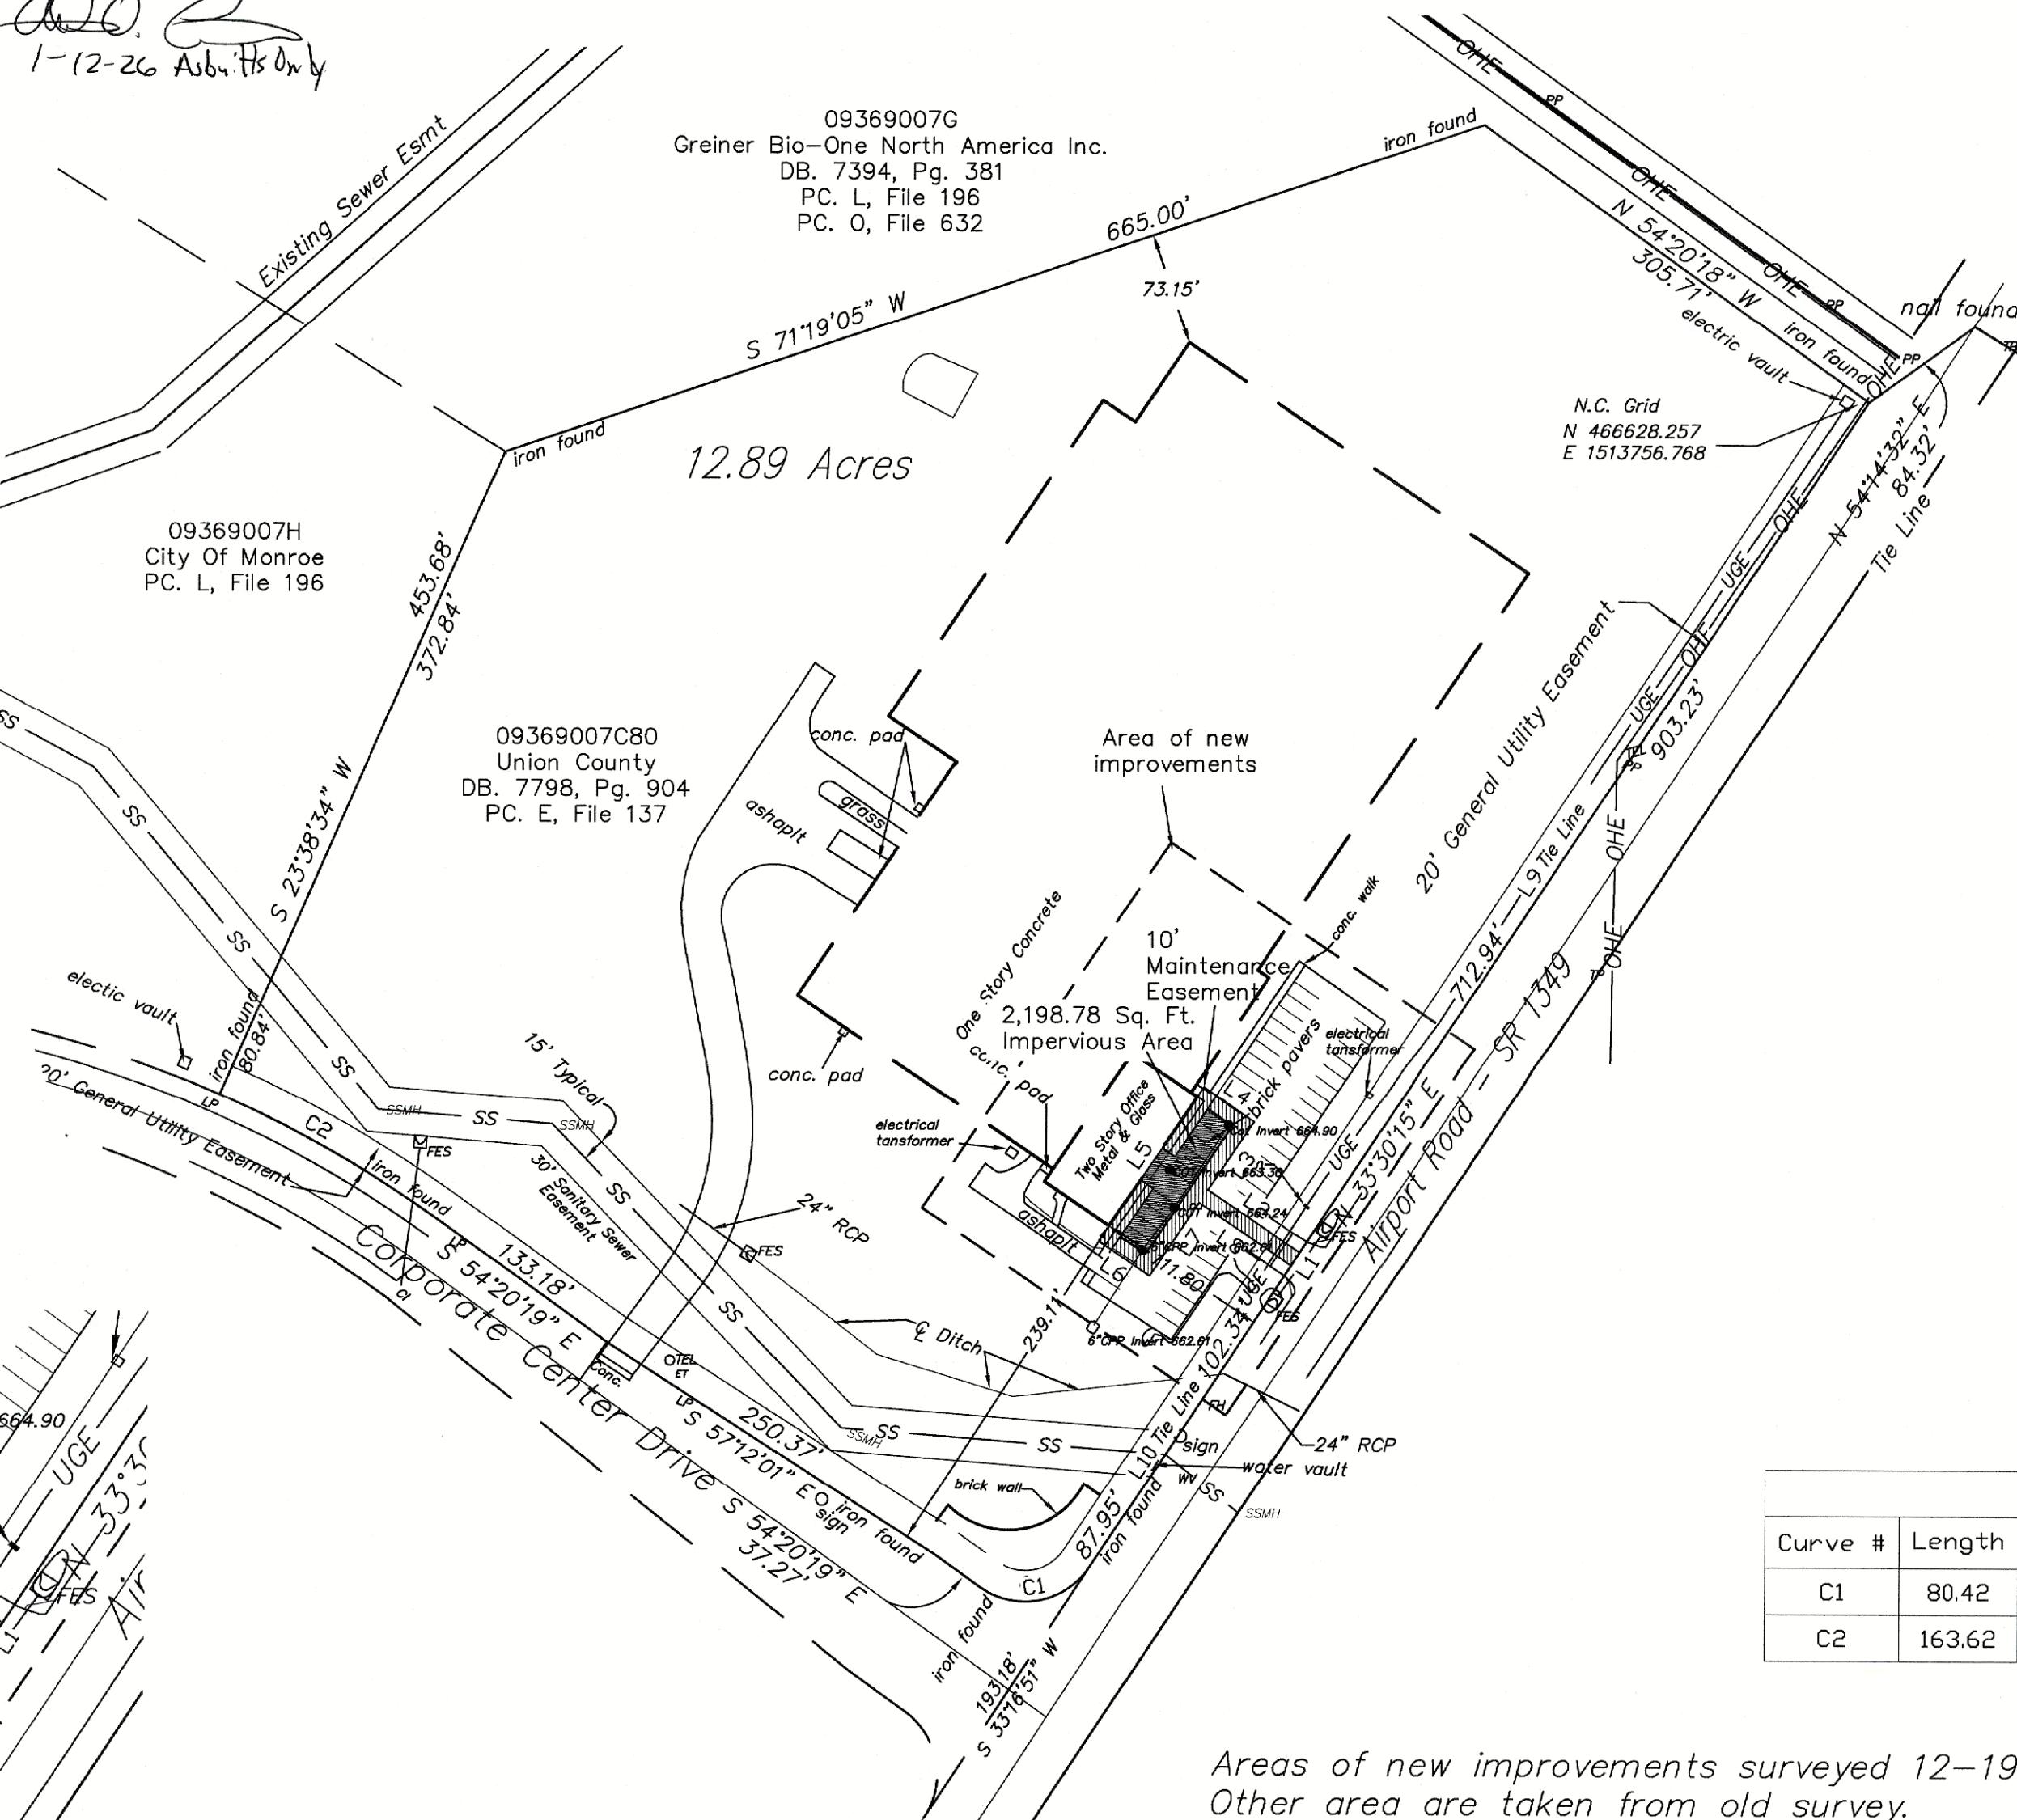

Areas of new improvements surveyed 12-19-25.
Other areas are taken from old survey.

45 parking spaces plus
2 handicap spaces.

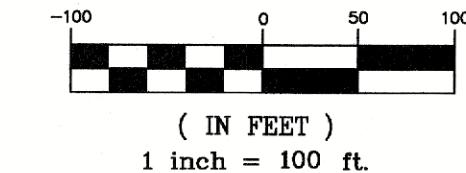

*New Addition Asbuilt Survey for
Union County Progress Building Parking lot
City of Monroe, Monroe Township, Union County, NC*

City of Monroe, Monroe Township, Union County, NC

Orig. scale: 1" = 100' Date: December 23, 2025 Drawn By: MSC

REVISIONS

-8-2026 AOL

CADL:10007 County Progress Building|10007 WORKING MSC 12-22-25.dwg 1/12/2026 bv: Drew Lawrence

Job No. 0007 Drawing file: Asbuilt.dwg Drawing no. 25/276